



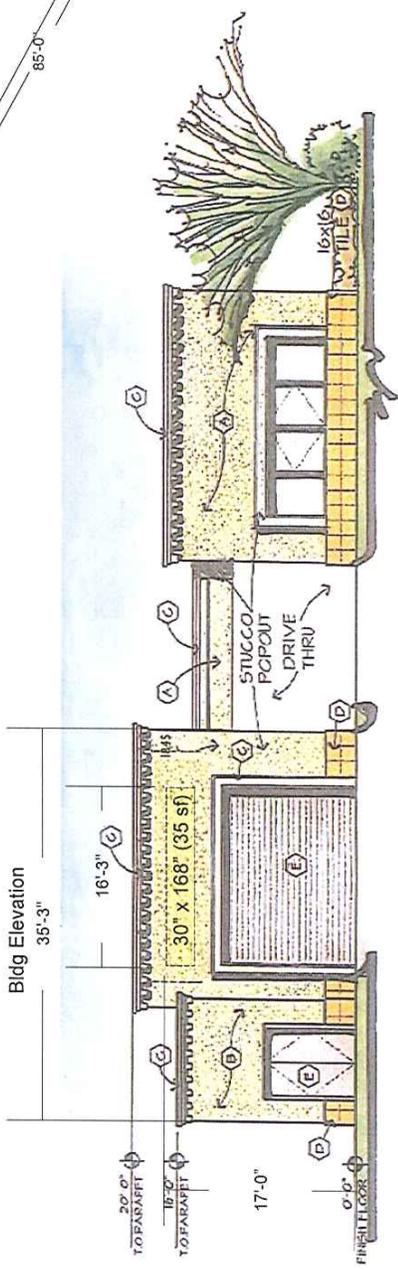

SIGN PACKAGE CRITERIA

DATE	01/07/11
PROJECT NAME	Wash Wizard Auto Spa Center
PROJECT ADDRESS	1845 E. University Dr.
TYPE	Individual pan channel letters
ILLUMINATION	Neon or LED
MATERIAL	Aluminum
CONSTRUCTION	
LETTER STYLE	Open
LOGO	Restricted to 25% of sign area – DRC policy.
COLOR	Open, trim cap and returns to be gold
SIZE RESTRICTION	48" sign height maximum. Limited to 80% or less of horizontal and vertical backgrounds.
INSTALLATION	Refer to drawing. One sign per building elevation for each business.
WINDOW SIGNAGE	Window signs are restricted to 25% of the individual window in which the sign is located.
CENTER ID	
MAJOR/PAD TENANT VARIATION	
MULTI-TENANT SIGN	Refer to drawing.

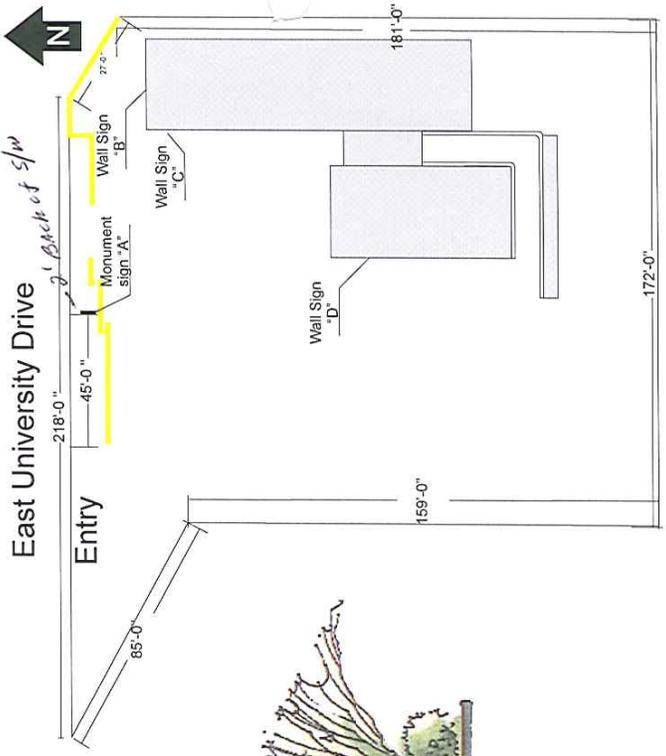

Double face internally illuminated cabinet.

1.5" x 1.5" x 3/16" angle aluminum frame.

.063 painted aluminum sides, base and cap.

.125" routed, painted aluminum faces with stud mounted translucent .125" acrylic backgrounds.

Acrylic to be decorated with translucent vinyl copy and/or digital print graphic overlays.

Lighting will be F72HO fluorescent lamps and appropriate ballast

Background painted Mathews Matte Black

Letters: white acrylic stud mounted to back of routed face


Star is routed with white background acrylic and translucent digital print overlay.



Background painted Mathews Matte Black

Letters: White acrylic with Gerber Gold Nugget translucent vinyl overlay

Star: white background acrylic and translucent digital print overlay.

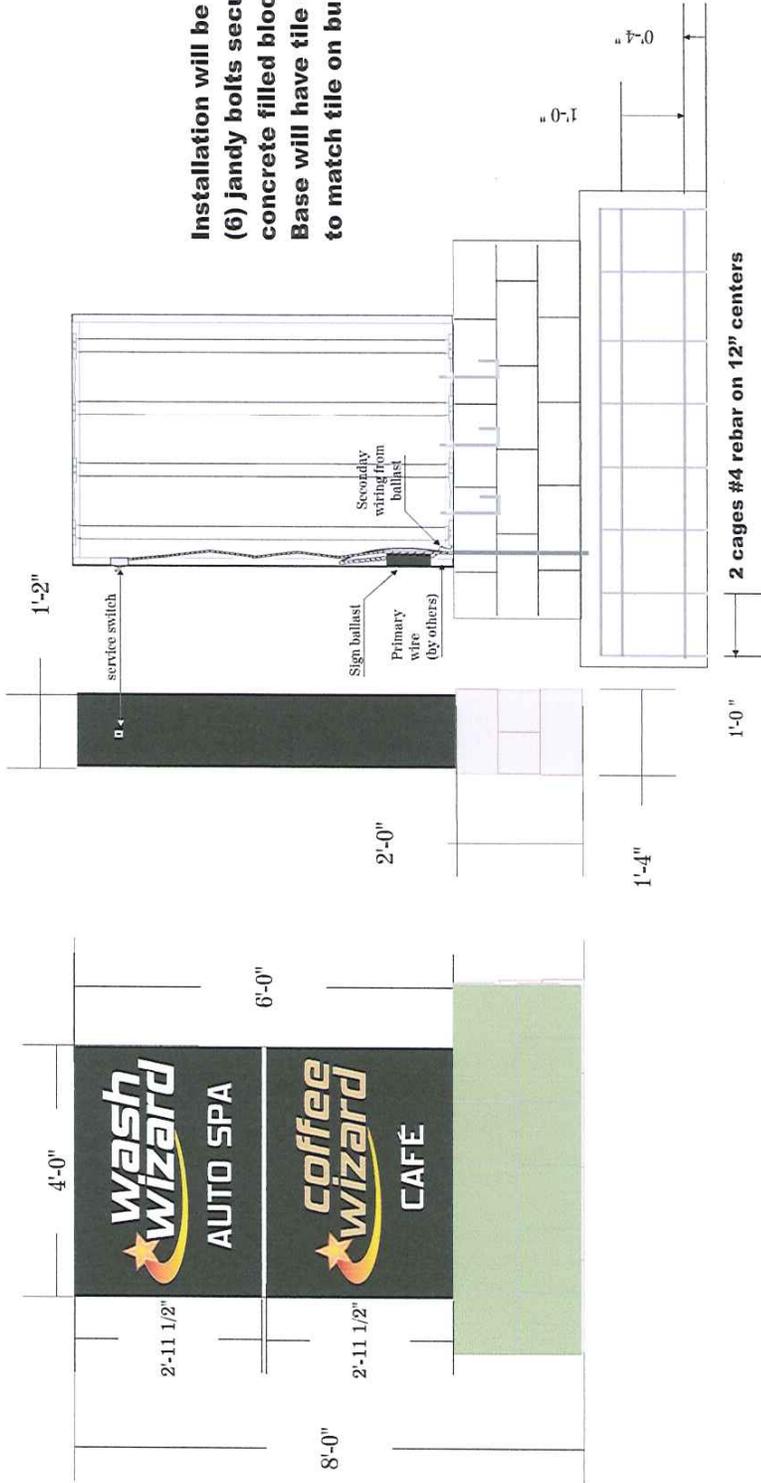

Installation will be on six (6) jandy bolts secured in concrete filled block base. Base will have tile on face to match tile on buildings

WESTERN
Signs & Lighting
 P O Box 41662
 Mesa, Arizona 85274
 OFFICE 480-331-8600 FAX 480-331-8601

Client: Hanna Development, Inc
 Wash Wizard Auto Spa
 1845 E. University Dr.
 Tempe, AZ 85281

ACCT REP: LARRY SMITH
 602-451-1336
 WESTERN@SMITH@COX.NET
 DATE: 12.24.10
 SCALE: 3/8" = 1'

CUSTOMER APPROVAL
 Approved without exception Approved as noted & initiated

PLEASE NOTE: ALL PRINTED COLORS ARE REPRESENTATIONS AND MAY NOT BE ACCURATE. THIS SIGN SHALL BE MANUFACTURED IN ACCORDANCE WITH THE REQUIREMENTS OF ARTICLE 600 OF THE NATIONAL ELECTRICAL CODE AND/OR OTHER APPLICABLE LOCAL CODES. THIS INCLUDES PROPER GROUNDING AND BONDING OF THIS SIGN.